

Rhif y Cais / Application Number : C14/1197/22/LL

Cynllun lleoliad ar gyfer adnabod y safle yn unig. Dim i raddfa.
Location Plan for identification purposes only. Not to scale.




CYNLLUN DIWYGIEDIG

REVISED PLAN




Derbyniwyd/Received
Llofnod/signature


07/10/15

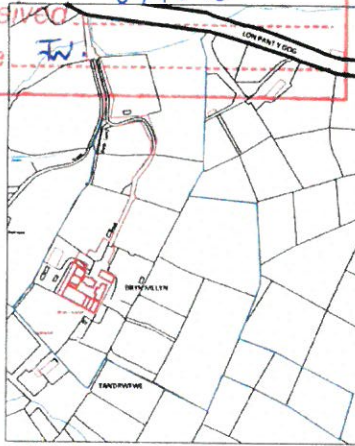


Location Plan @ 1:2500

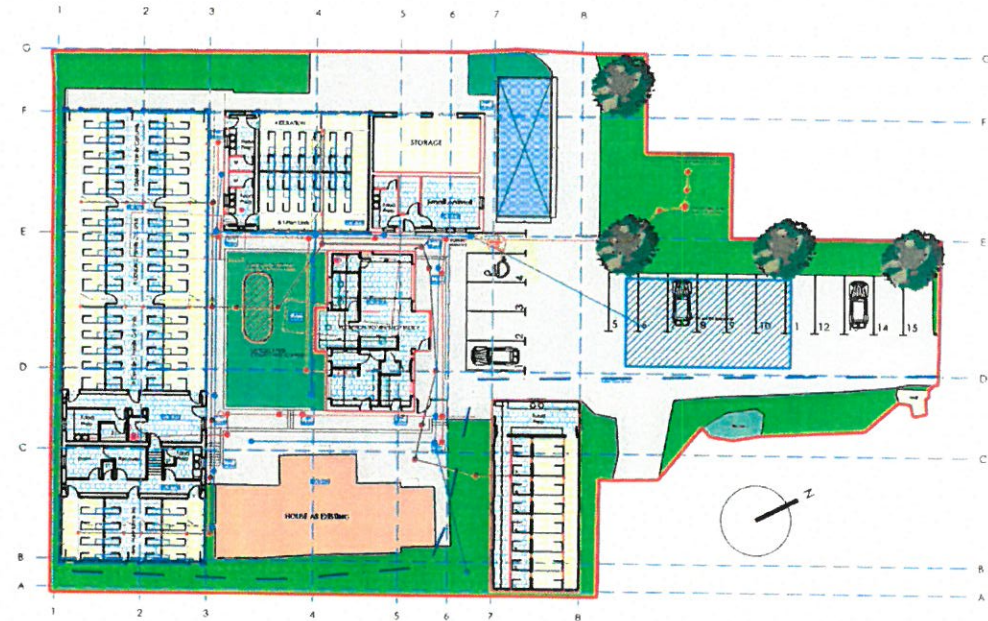

Grid Plan @ 1:200

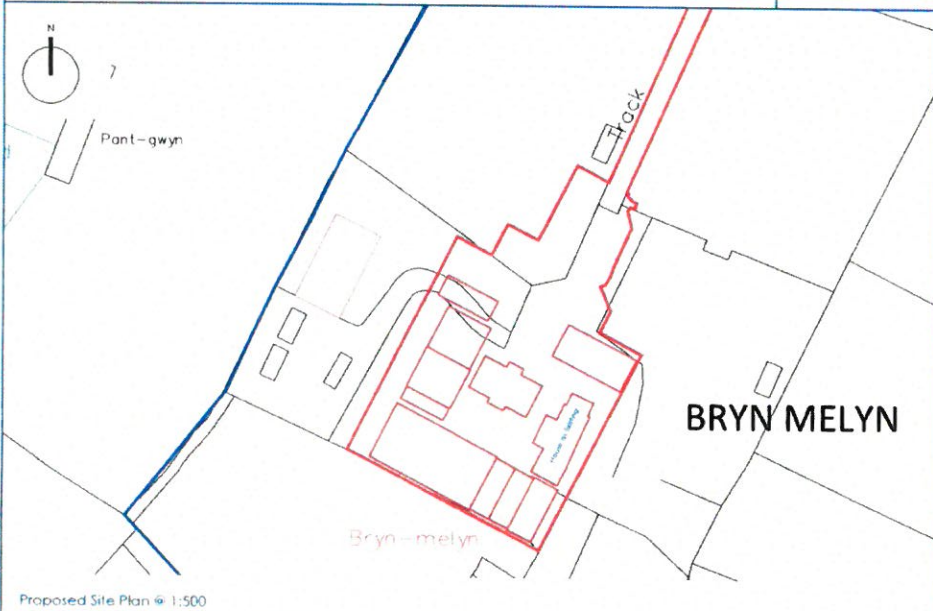

Proposed Site Plan @ 1:500

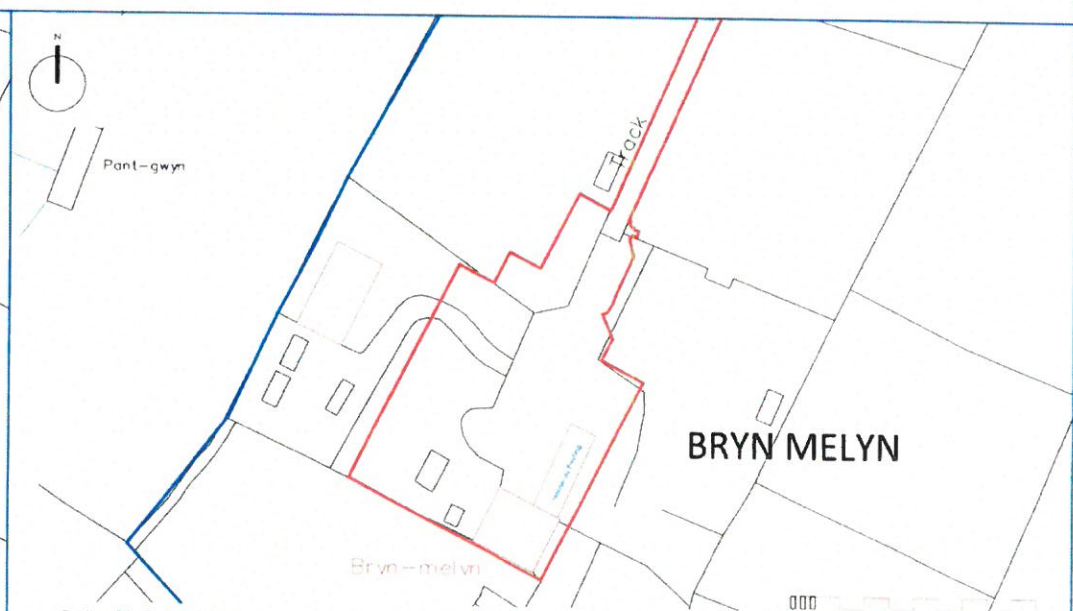

Existing Site Plan @ 1:500

DESCRIPTION	REV	DATE	DRWN	APPR
Position of red line amended	1.00	18/02/15	BE	
Change of kennel layout. Removal of parking space. Public Right of Way added	2.00	06/05/15	BE	
Enclosed wall to kennel exercise runs added	3.00	07/10/15	BE	

Kennelbuild
Bespoke & Modular Kennel and Cattery Systems

Unit 10 Wheelock
Health
Business Court
Alsager Road,
Wintery,
CW11 4RQ

mikeupton
T: 01270 753 493
E: info@kennelbuild.co.uk
W: kennelbuild.co.uk

PROPOSED NEW ANIMAL WELFARE FACILITIES

FRESHFIELDS

Location Site and Grid Plan

DRAWING NUMBER

D-1126-1-14-LOC01

SCALE


1:100 @ A1

DATE


NOVEMBER 2014

CONWY 01492 583036
DENBIGH 01745 817168
e: admin@matthewjonesarchitects.com
web: www.matthewjonesarchitects.com

matthewjonesarchitects

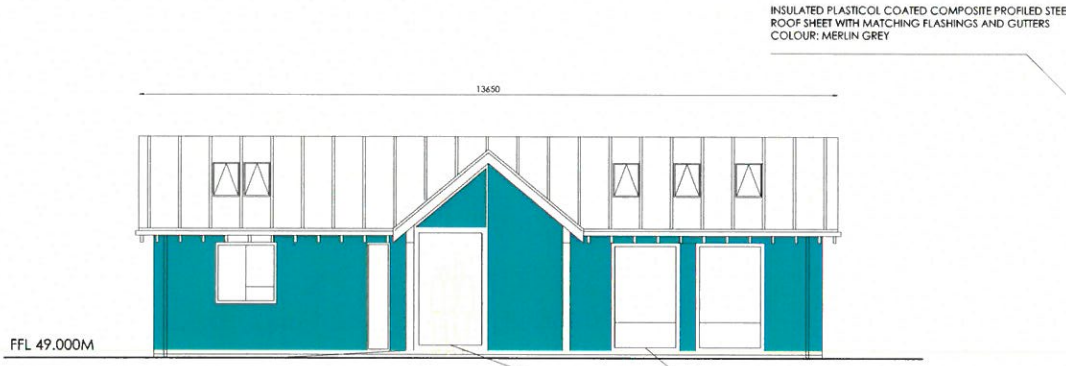


Front Elevation

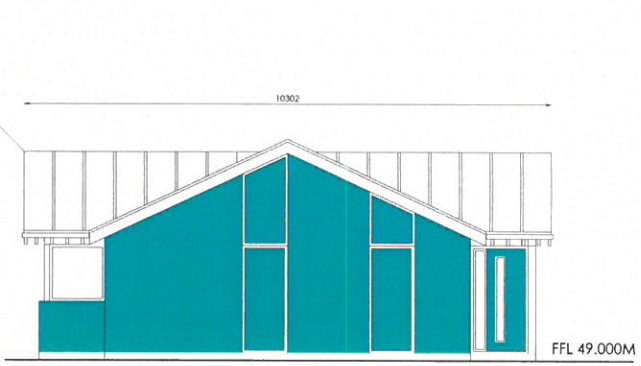


Side Elevation

ALUMINIUM FRAMED POWDER COATED WINDOWS AND DOORS WITH SEALED DOUBLE GLAZED UNITS COLOUR: DARK GREY

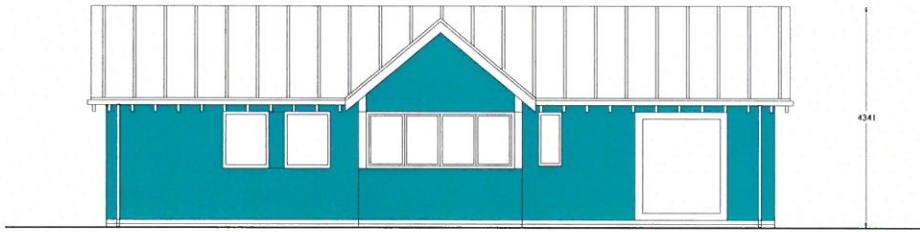


Rear Elevation

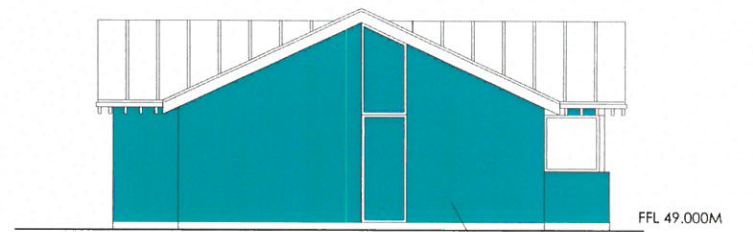


Side Elevation

PAINTED BLOCKWORK WALLS COLOUR: WHITE




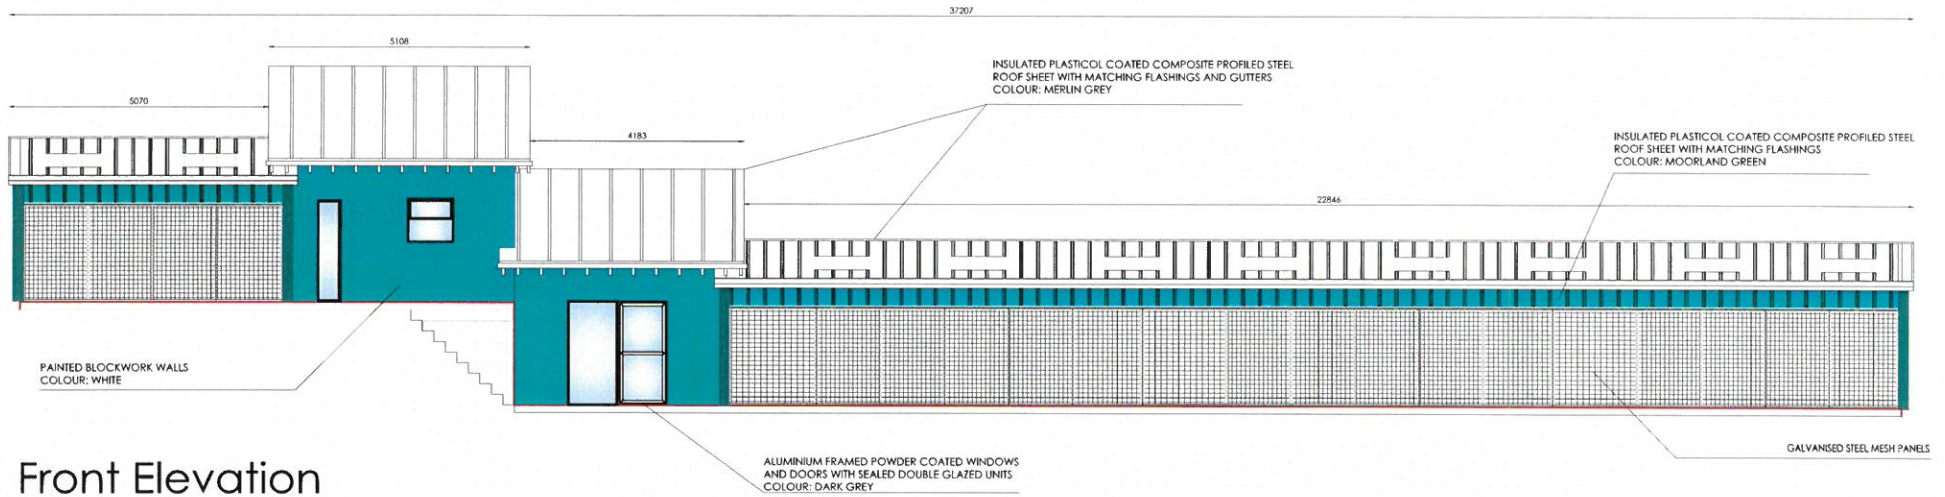


Front Elevation

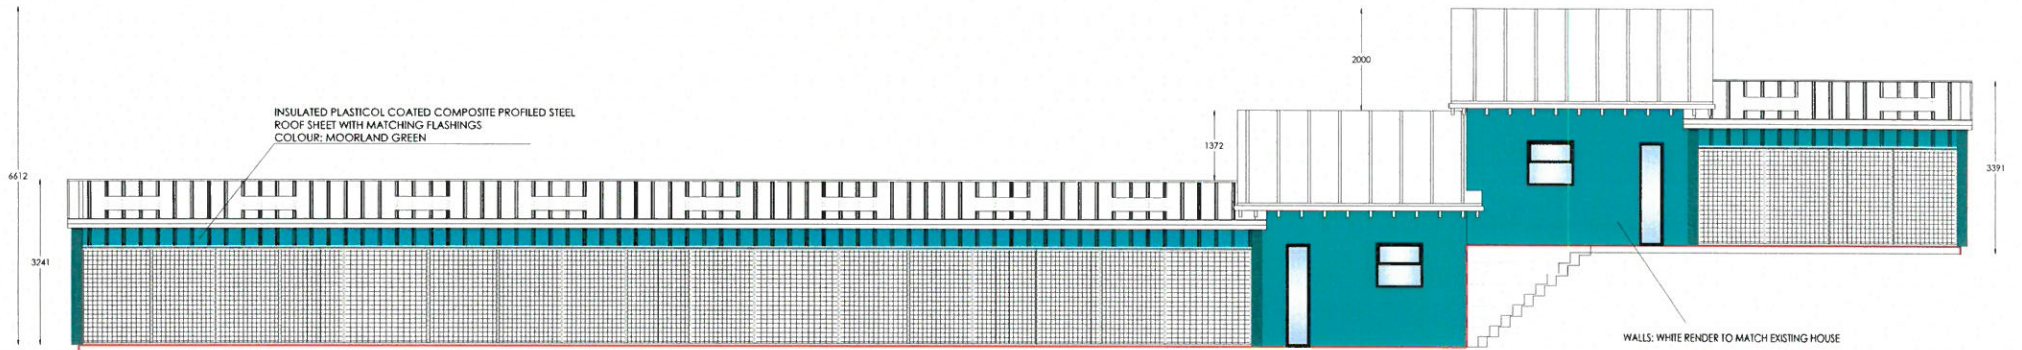

Rear Elevation

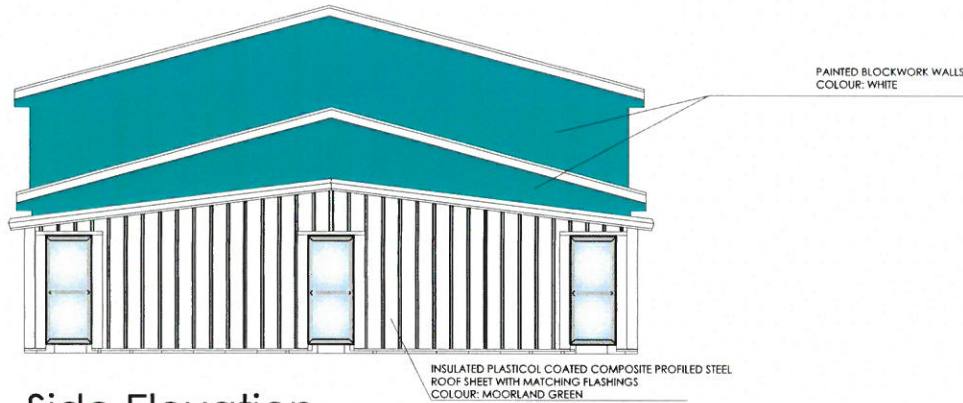

Side Elevation

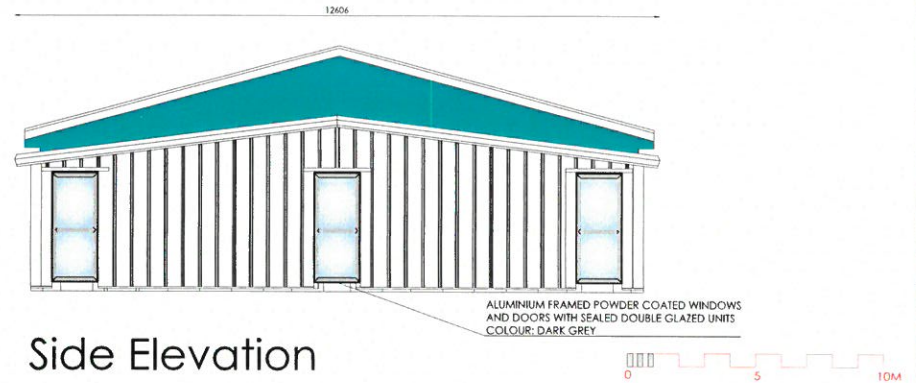

Side Elevation

Kennelbuild
Bespoke & Modular Kennel and Cattery Systems

Unit 10 Wheelock Heath
Business Court
Alsager Road,
Winterly,
CW11 4RQ

mikeupton
T: 01270 753 493
E: info@kennelbuild.co.uk
W: kennelbuild.co.uk

PROPOSED NEW ANIMAL WELFARE FACILITIES
FRESHFIELDS CATTERY ELEVATIONS

DRAWING NUMBER
D-1126-1-14-PL05

SCALE
1:50 @ A1


DATE
NOVEMBER 2014

matthewjonesarchitects

CONWY 01492 583036
DENBIGH 01745 817169
e: admin@matthewjonesarchitects.com
web: www.matthewjonesarchitects.com

INSULATED PLASTICOL COATED COMPOSITE PROFILED STEEL ROOF SHEET WITH MATCHING FLASHINGS AND GUTTERS
COLOUR: MERLIN GREY


ALUMINIUM FRAMED POWDER COATED WINDOWS AND DOORS WITH SEALED DOUBLE GLAZED UNITS
COLOUR: DARK GREY

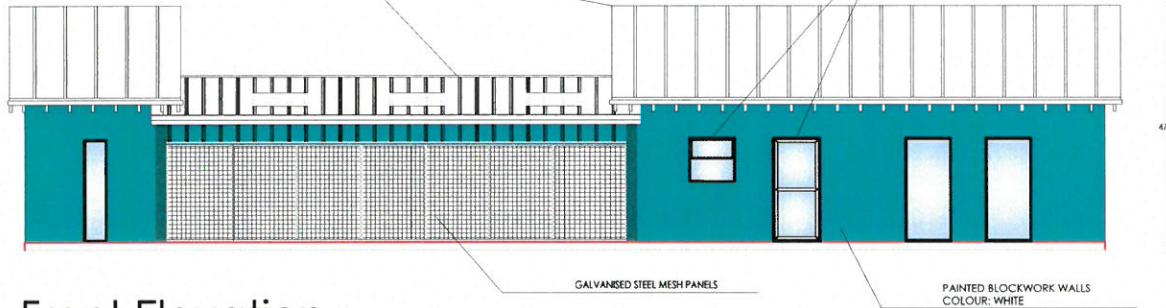

Front Elevation

GALVANISED STEEL MESH PANELS


PAINTED BLOCKWORK WALLS
COLOUR: WHITE

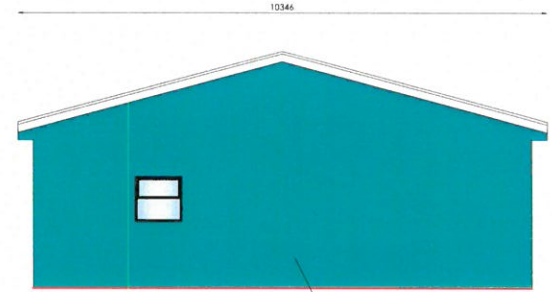

Side Elevation

PAINTED BLOCKWORK WALLS
COLOUR: WHITE

21688

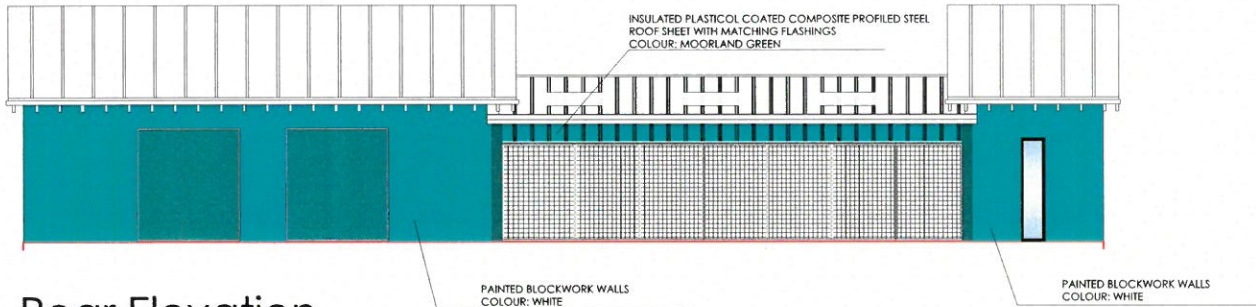


Rear Elevation

PAINTED BLOCKWORK WALLS
COLOUR: WHITE

PAINTED BLOCKWORK WALLS
COLOUR: WHITE

INSULATED PLASTICOL COATED COMPOSITE PROFILED STEEL ROOF SHEET WITH MATCHING FLASHINGS
COLOUR: MOORLAND GREEN

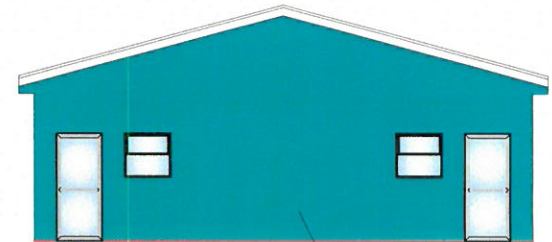

Side Elevation

PAINTED BLOCKWORK WALLS
COLOUR: WHITE



Kennelbuild
Bespoke & Modular Kennel and Cattery Systems

Unit 10 Wheelock
Heath
Business Court
Alasager Road,
Winterly,
CW11 4RQ

mikeupton
T: 01270 753 493
E: info@kennelbuild.co.uk
W: kennelbuild.co.uk

PROPOSED NEW ANIMAL WELFARE FACILITIES

FRESHFIELDS

KITTEN and ISO UNIT

DRAWING NUMBER

D-1126-1-14-PL06

SCALE

1:50 @ A1


DATE

NOVEMBER 2014

matthewjonesarchitects

CONWY 01492 583035
DENBIGH 01745 817169
e: admin@matthewjonesarchitects.com
web: www.matthewjonesarchitects.com


50.00m Datum
Elevation on 1 1

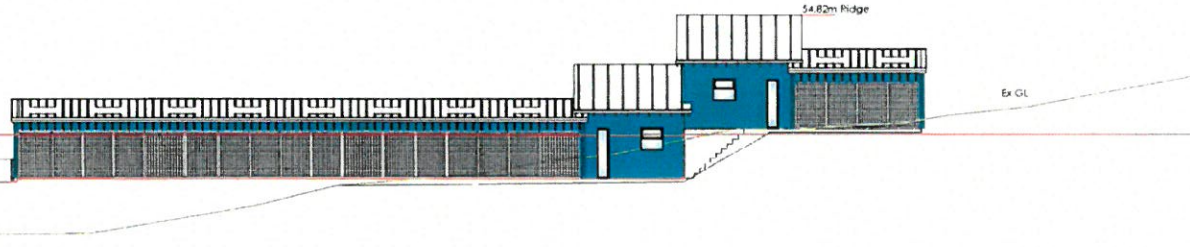


**CYNLLUN DIWYBODAETH
REVISED PLAN**

Derbyniwyd/Received 07/10/15
Llofnod/signature Jw


50.00m Datum
Elevation on 3 3

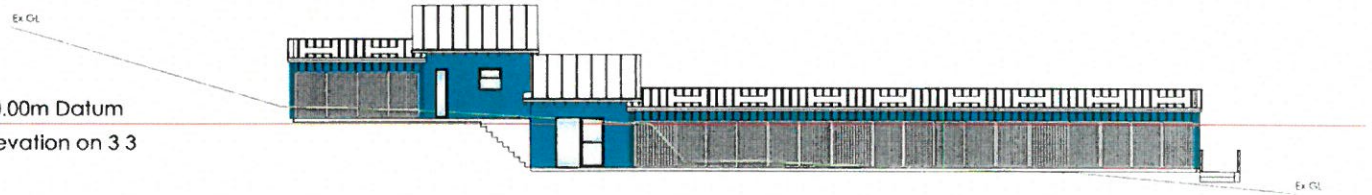


50.00m Datum
Elevation on 6 6

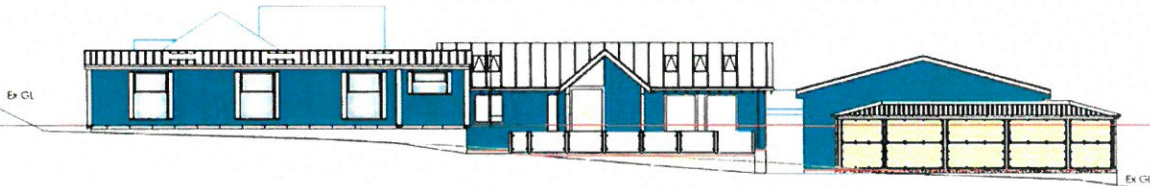

50.00m Datum
Elevation on E E

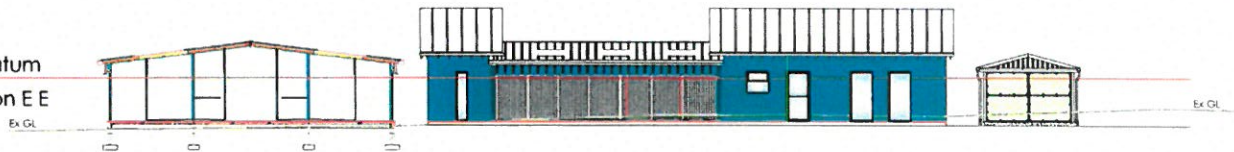

50.00m Datum
Elevation on F F

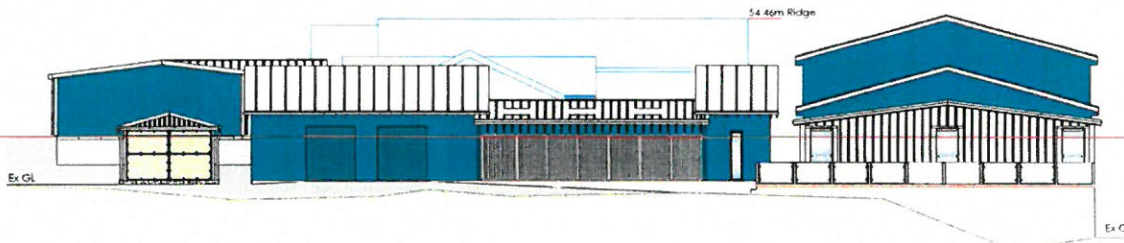

DESCRIPTION	REV	DATE	DRWN	APPR
External appearance details amended	1.00	18/02/15	RE	
Enclosed wall to kennel exercise runs added	2.00	07/10/15	BE	

Kennelbuild
Respoke & Modular Kennel and Cattery Systems

Unit 10 Wheelock
Health
Business Court
Alasager Road,
Winterly,
CW11 4RQ

mikeupton
T: 01270 753 493
E: info@kennelbuild.co.uk
W: kennelbuild.co.uk


PROPOSED NEW ANIMAL WELFARE FACILITIES
FRESHFIELDS ELEVATIONS

DRAWING NUMBER
D-1126-1-14-PL07

SCALE
1:100 @ A1


DATE
NOVEMBER 2014

matthewjonesarchitects
CONWAY 01492 583036
DENBIGH 01745 817169
e: admin@matthewjonesarchitects.com
web: www.matthewjonesarchitects.com

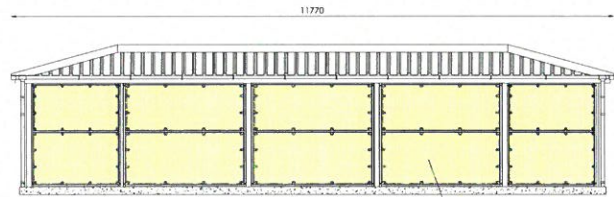


Front Elevation

25mm x 25mm GALVANISED STEEL BOX SECTION WITH OPAL PETG (ACRYLIC) INFILL

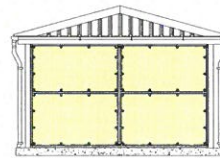


Side

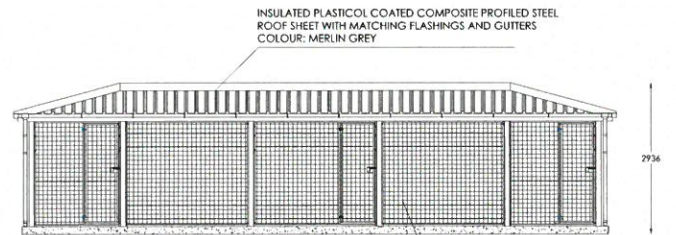


Rear Elevation

GALVANISED STEEL MESH PANELS

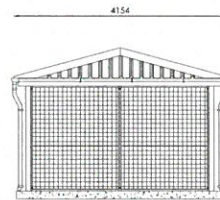

Side

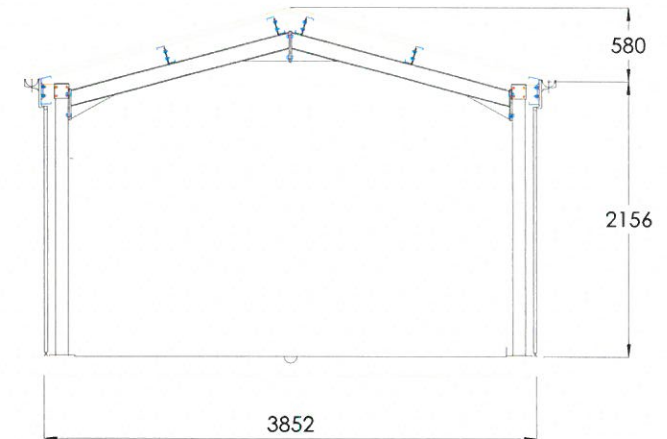


Section 1:20



CYNLLUN DIWYGIEDIG REVISED PLAN


Derbyniwyd/Received 07.10.15

Llofnod/signature FW

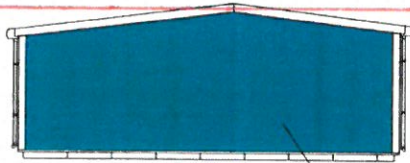


Side Elevation

INSULATED PLASTIC COATED COMPOSITE PROFILED STEEL
ROOF SHEET WITH MATCHING FLASHINGS
COLOUR: MOORLAND GREEN

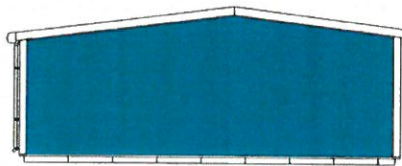

Side Elevation

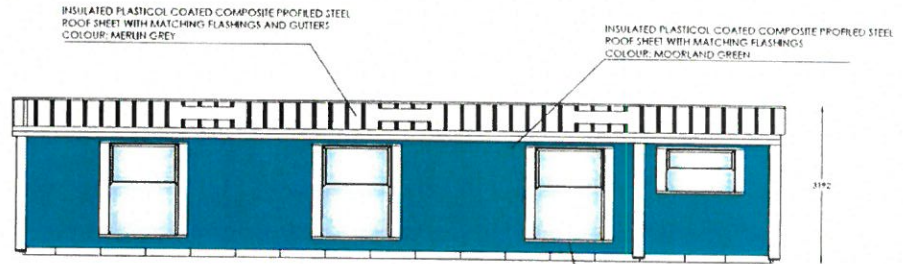


Front Elevation

INSULATED PLASTIC COATED COMPOSITE PROFILED STEEL
ROOF SHEET WITH MATCHING FLASHINGS AND GUTTERS
COLOUR: MERLIN GREY

INSULATED PLASTIC COATED COMPOSITE PROFILED STEEL
ROOF SHEET WITH MATCHING FLASHINGS
COLOUR: MOORLAND GREEN

ALUMINIUM FRAMED POWDER COATED WINDOWS
AND DOORS WITH SEALED DOUBLE GLAZED UNITS
COLOUR: DARK GREY

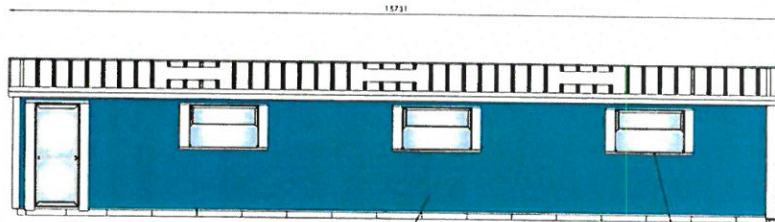

Rear Elevation

INSULATED PLASTIC COATED COMPOSITE PROFILED STEEL
ROOF SHEET WITH MATCHING FLASHINGS
COLOUR: MOORLAND GREEN

ALUMINIUM FRAMED POWDER COATED WINDOWS
AND DOORS WITH SEALED DOUBLE GLAZED UNITS
COLOUR: DARK GREY

DESCRIPTION	REV	DATE	DRWN	APPR
External appearance details amended	1.00	18/02/15	BE	
New Elevations to Reflect Revised Layout	2.00	06/05/15	BE	
Enclosed wall to kennel exercise runs added	3.00	07/10/15	BE	

Kennelbuild
Bespoke & Modular Kennel and Cattery Systems

Unit 10 Wheelock
Heath
Business Court
Alasager Road,
Winterly,
CW11 4RQ

mikeupton
T: 01270 753 493
E: info@kennelbuild.co.uk
W: kennelbuild.co.uk

PROPOSED NEW ANIMAL WELFARE FACILITIES
FRESHFIELDS

KENNEL AND FERAL CAT ELEVATIONS

DRAWING NUMBER
D-1126-1-14-PL09

SCALE
1:50 @ A1

DATE
NOVEMBER 2014

CONWY 01492 583036
DENBIGH 01745 817169
e: admin@matthewjonesarchitects.com
web: www.matthewjonesarchitects.com

matthewjonesarchitects